
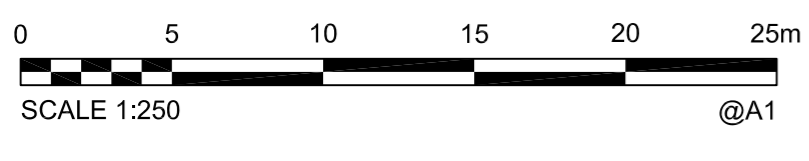
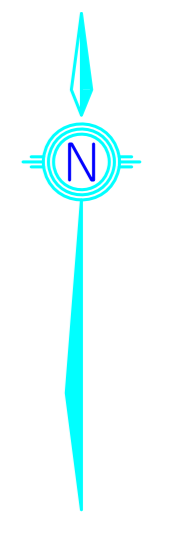


SYMBOL TABLE	
SYMBOL	DEFINITION
	AIR VALVE
	FIRE HYDRANT
	WATER METER
	WATER VALVE
	WATER TAP
	GAS VALVE
	GAS METER
	COMMUNICATIONS PIT
	COMMUNICATIONS PILLAR
	ELECTRICITY PIT
	ELECTRICITY PILLAR
	LIGHT POLE OR AS MARKED
	TRAFFIC LIGHT
	TRAFFIC SIGNAL BOX/PIT
	POWER POLE
	POLE GROUND STAY
	SEWER MANHOLE
	DRAINAGE MANHOLE
	FIELD INLET/GULLY TRAP
	SIGN POST/BOLLARD
	BENCHMARK/SURVEY STATION
	UNKNOWN SERVICE

LINETYPE TABLE	
LINETYPE	DEFINITION
	SUBJECT LOT BOUNDARY
	ADJOINING LOT BOUNDARY
	EASEMENT/LEASE BOUNDARY
	BUILDING
	GUTTER/FASCIA
	FENCELINE
	TOP/BOTTOM OF BANK
	CHANGE OF GRADE
	DRAINAGE
	ELECTRICAL
	SEWERAGE
	TELSTRA/COMMS
	WATER
	VEGETATION

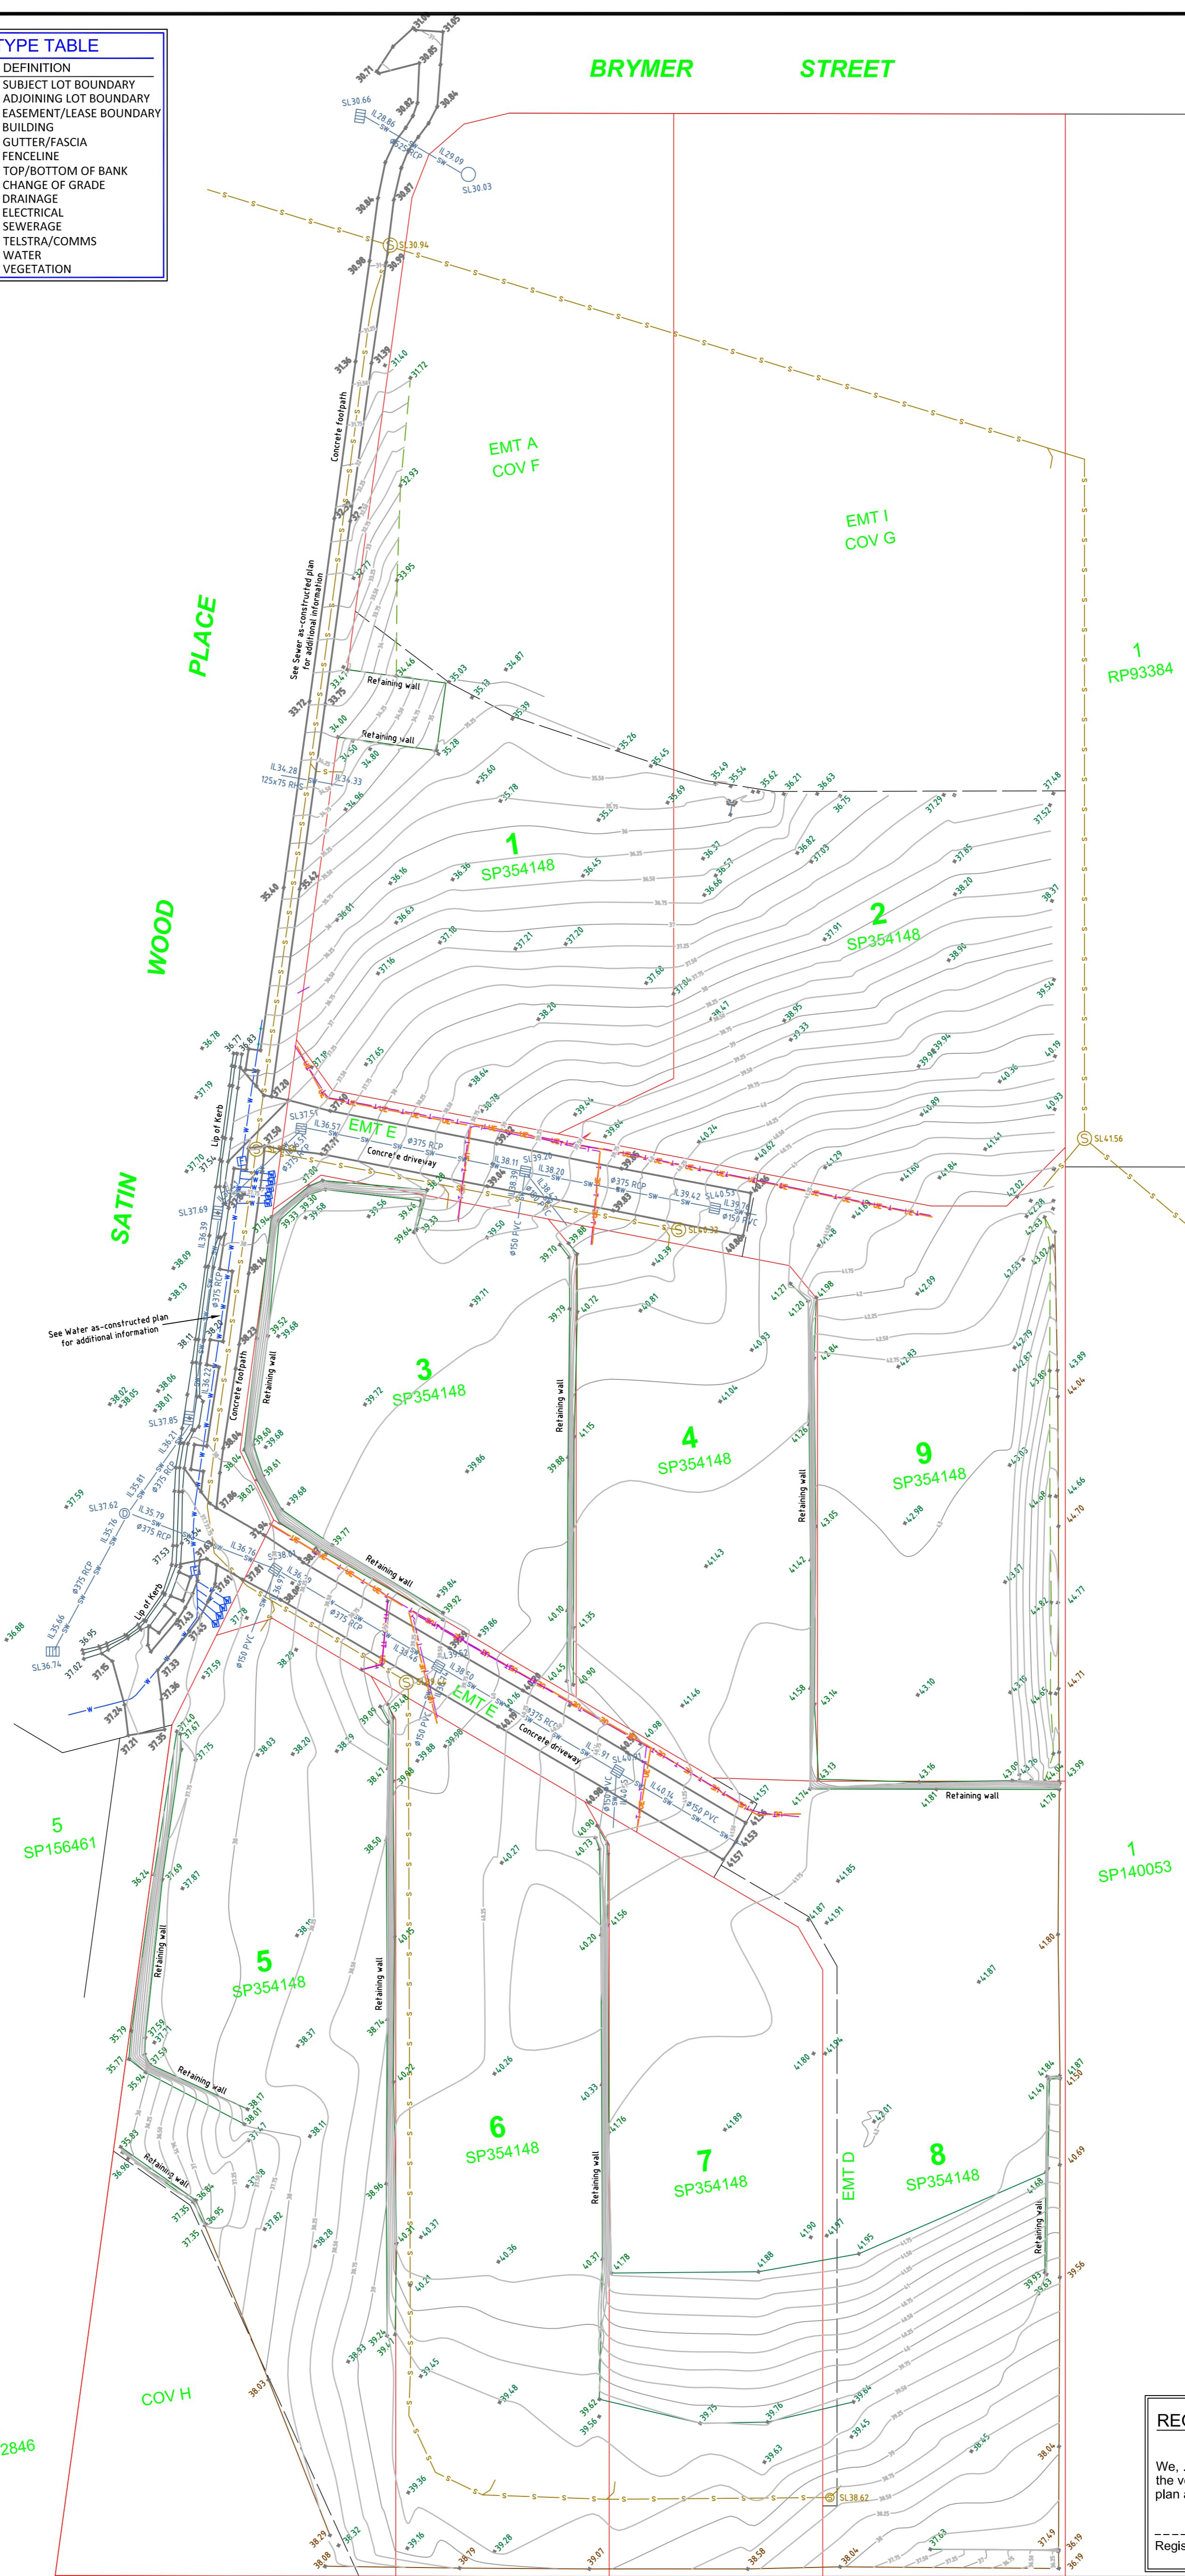

**REGISTERED SURVEYOR'S CERTIFICATION**

We, Brisbane Survey Group Pty Ltd, hereby certify that the vertical and horizontal locations and dimensions shown on this plan are a true and correct record and were located by survey.

6338 06/01/2026  
 Registered Surveyor (Old) (sig.) Reg. Surveyor No. Date

**GENERAL NOTES**

Contour Interval 0.5m  
 Boundaries have been accurately positioned vide SP354148.  
 North Point is indicative only & may not be an accurate representation of True North.  
 If in doubt contact Lawson Surveys.

<b>PLAN SHOWING AS-CONSTRUCTED DETAIL</b>		CLIENT <b>URBEX PTY LTD</b>	 <b>LAWSON SURVEYS</b> <small>© COPYRIGHT PROTECTS THIS PLAN. Unauthorised reproduction or amendment not permitted. Please contact the author.</small>	A.B.N 46 272 949 047 CONSULTING LAND SURVEYORS 9B / 62 BISHOP STREET KELVIN GROVE OLD 4059 Ph 07 3352 3326 Fax 07 3352 6991 mail@lawsonsurveys.com.au www.lawsonsurveys.com.au						
LEVEL DATUM AHD - VIDE PSM 11714 RL 45.727	SCALE <b>1:250 @ A1</b>	LOCATION <b>22 BRYMER STREET CHAPEL HILL</b>								
LOCAL AUTHORITY BRISBANE CITY COUNCIL	DATE 15/12/2025	RPD	REFERENCE <b>21595</b>	<table border="1"> <tr> <td>Rev 1 - DTM Changes</td> <td>06/01/2026</td> </tr> <tr> <td>Rev 0 - Initial Issue</td> <td>15/12/2025</td> </tr> <tr> <td><b>REVISION</b></td> <td><b>DATE</b></td> </tr> </table>	Rev 1 - DTM Changes	06/01/2026	Rev 0 - Initial Issue	15/12/2025	<b>REVISION</b>	<b>DATE</b>
Rev 1 - DTM Changes	06/01/2026									
Rev 0 - Initial Issue	15/12/2025									
<b>REVISION</b>	<b>DATE</b>									
MERIDIAN SP354148	SURVEYED BY SPK	PROPOSED LOTS 1-9 ON SP354148								
DWG NAME 21595-DTM 06-01-2026	DRAWN BY QSD									